
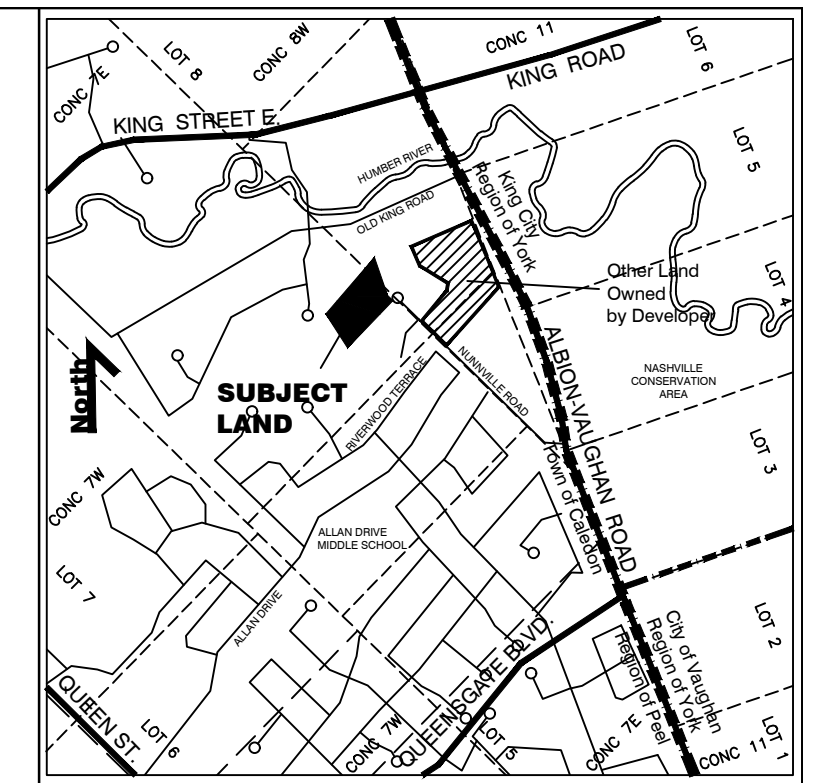
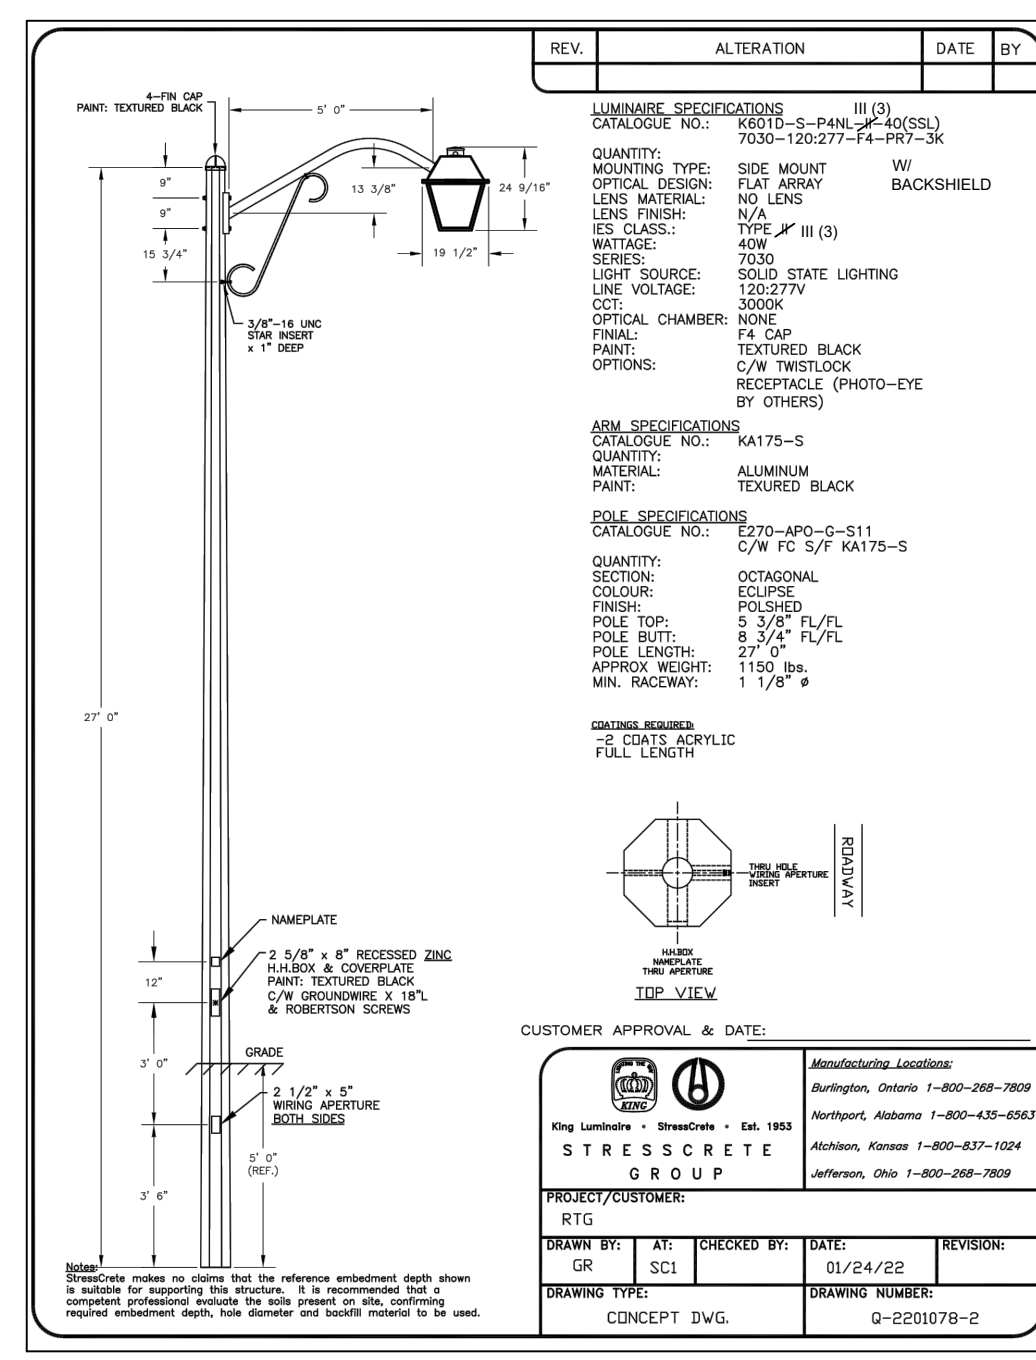


1306 8100

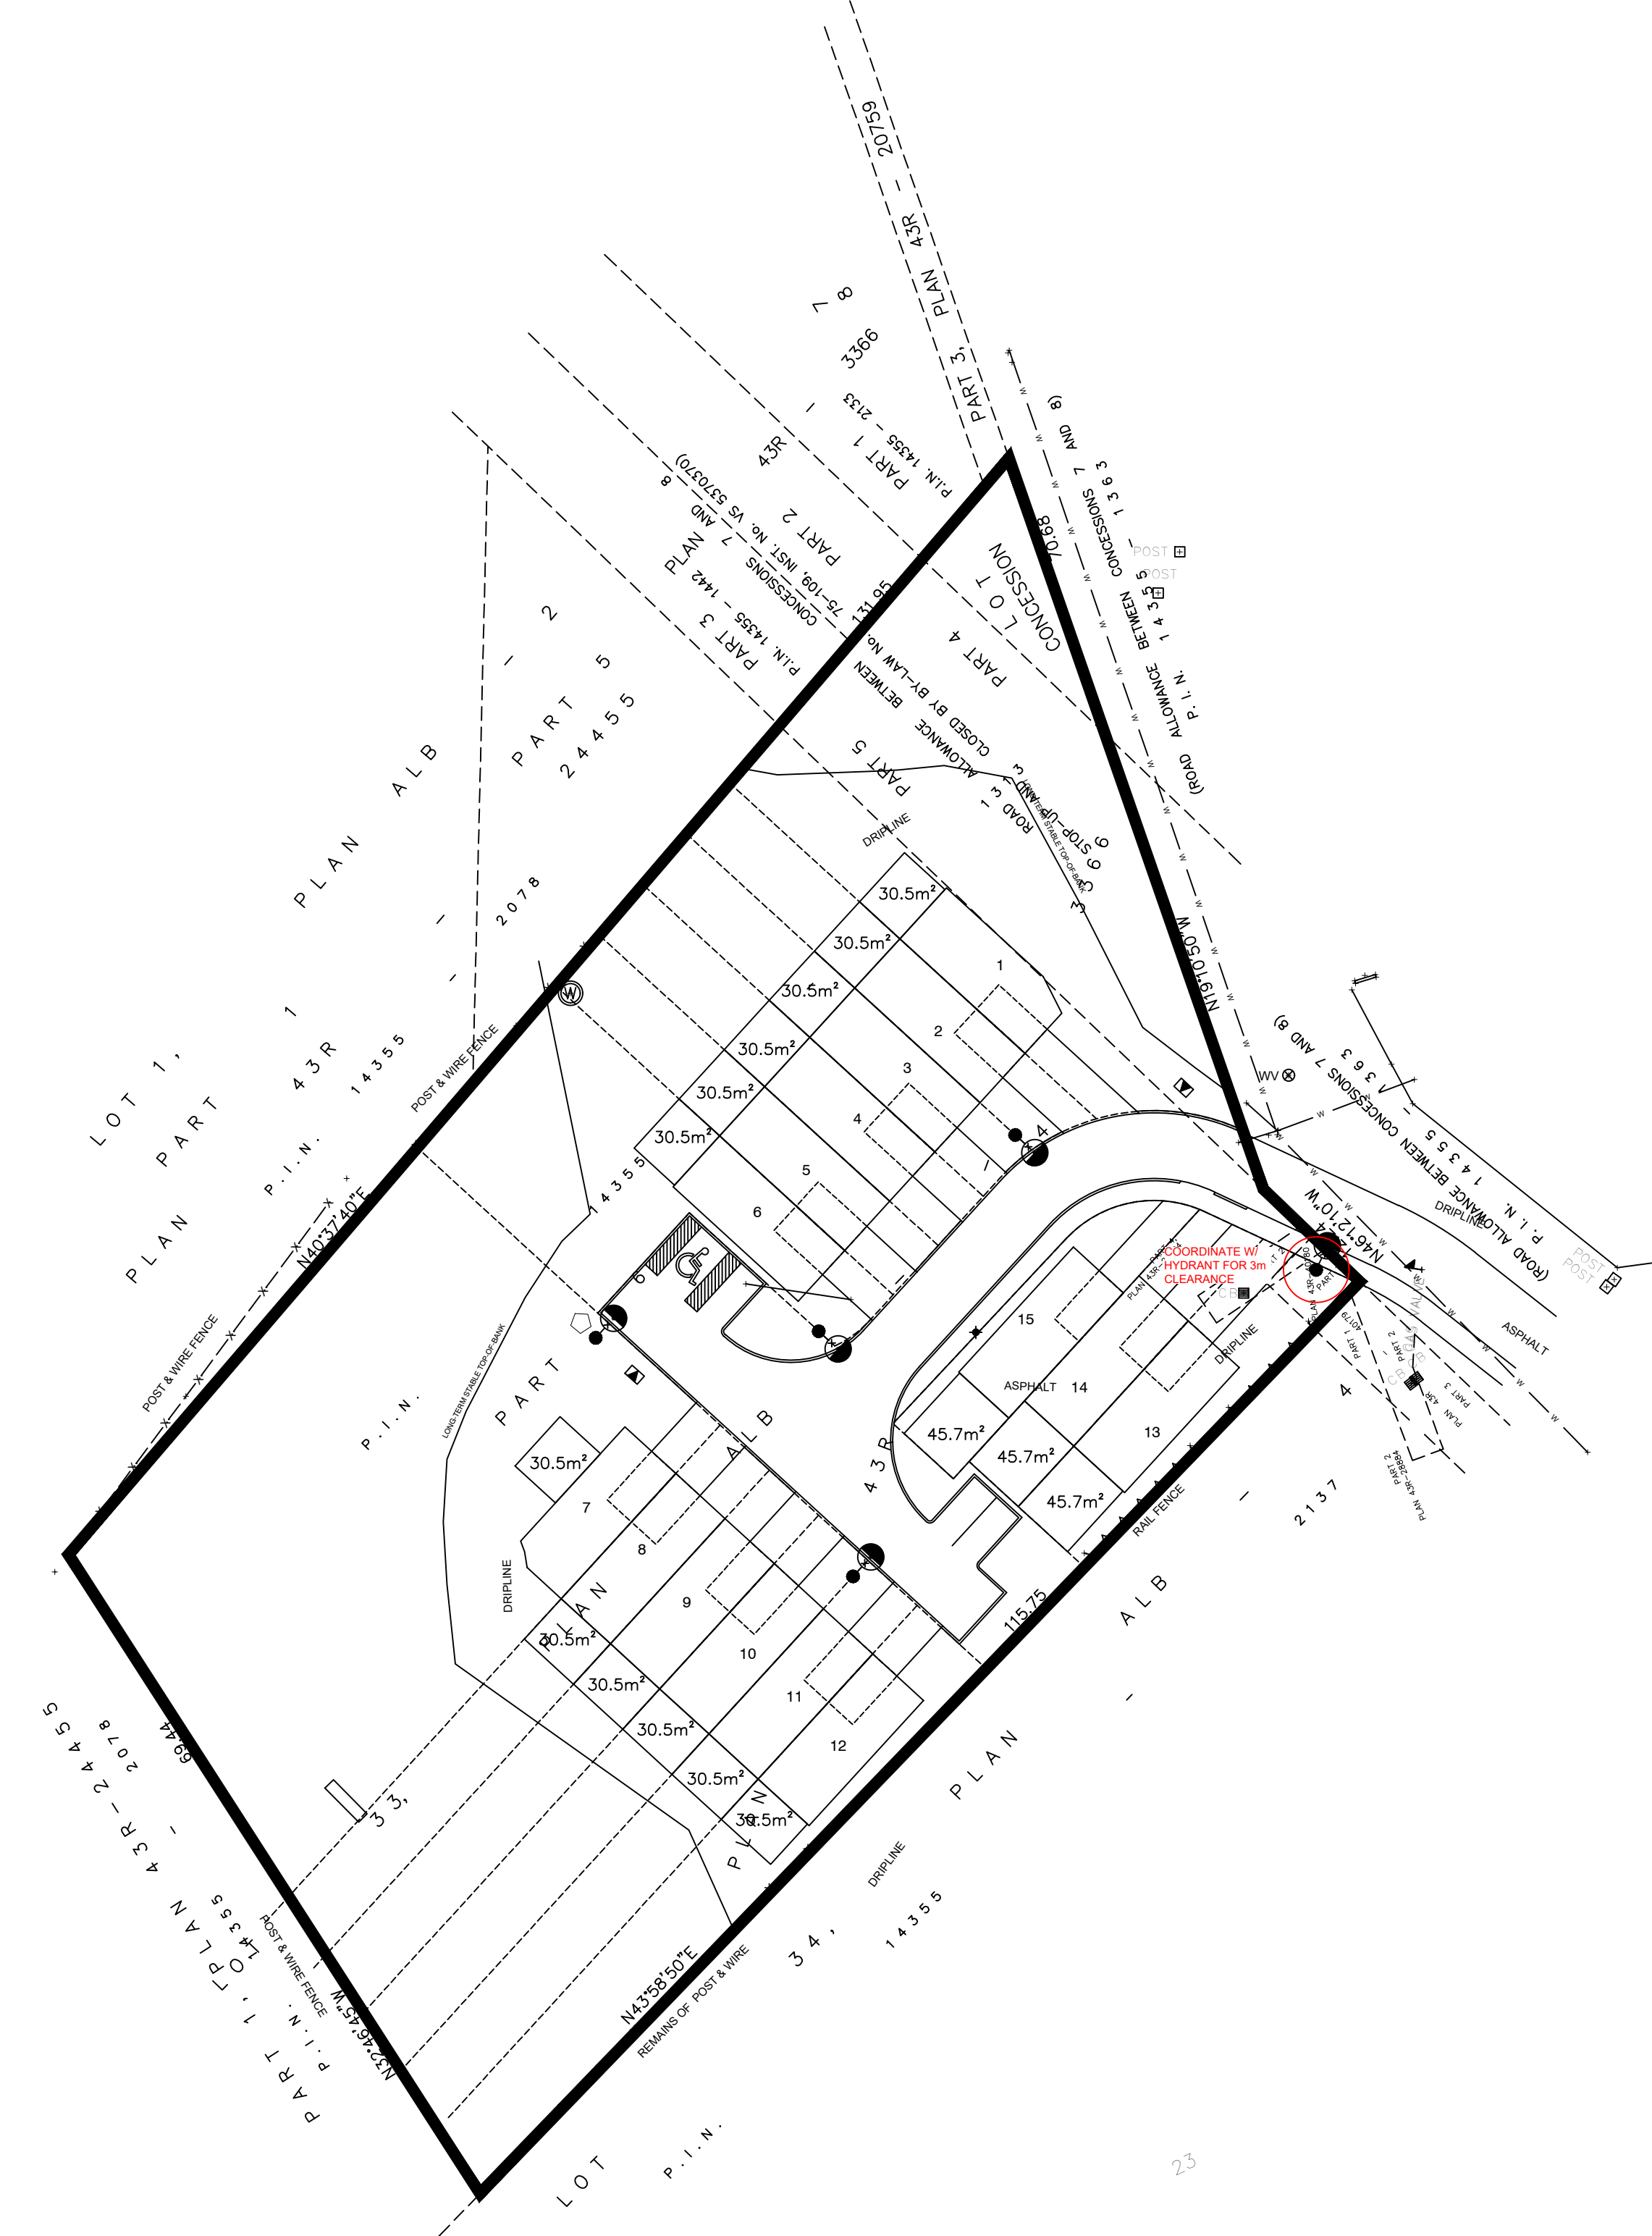


- KEY PLAN N.T.S.
- LEGEND
- SITELIGHT ASSEMBLY  
POLE: 8.2m (27') OCTAGONAL CONCRETE PRESTRESSED AND REINFORCED, BY STRESS-CRETE CAT.# E270-BPO-G-CSA C/W TOP CAP AND FINISHED IN POLISHED MIDNIGHT LACE CAT.# S-10  
ARM: 1.5m (5') DECORATIVE ARM WITH SCROLL  
LUMINAIRE: KING K601 TYPE III 40W 3000K CAT# K601D-S-III-P4NL-40-(SSL)-7030-120V C/W 7-PIN PHOTO CONTROL AND BACK SHIELD.  
NOTE: LUMINAIRE AND ARM TO BE FACTORY FINISHED POWDER COAT BLACK.
  - METERED POWER SUPPLY PEDESTAL TO BE MANUFACTURED BY PEDESTAL SOLUTIONS INC. (PSI), YORK, ONTARIO, CAT.#SLxxx1-#-40, 100A 2 POLE MAIN BREAKER, #-40A BRANCH BREAKERS. PROVISION FOR UP TO 12 BRANCH BREAKERS. WEATHER PROOF, TAMPER PROOF CABINET, DARK GREEN. PROVISIONS FOR PADLOCKING. MOUNT ON PRE-CAST CONCRETE FOUNDATION (US1 UP2022 BASE)
  - ⊕ PROPOSED GROUND ROD.
  - ⊠ HYDRO ONE TRANSFORMER.
  - STREETLIGHT CABLE: 2-#6RWJ C/W 1-#6 RWJ GND. CABLE INSTALLED IN 50mm PVC TYPE 2 DIRECT BURIED DUCT IN COMPLETE ACCORDANCE WITH E.S.A. STANDARDS & SPECIFICATIONS
  - STREETLIGHT PEDESTAL SUPPLY CABLE: 3-#2 Cu. RWJ-90 C/W JACKETED GND IN CONTINUOUS 50mm PVC TYPE 2 DUCT IN COMPLETE ACCORDANCE WITH E.S.A. STANDARDS & SPECIFICATIONS.
  - ⑭ MUNICIPAL NUMBER
  - HYDRO ONE VAULT.

APPROVED FOR CONSTRUCTION  
THIS APPROVAL CONSTITUTES A GENERAL REVIEW AND DOES NOT CERTIFY DIMENSIONAL ACCURACY.

THIS APPROVAL IS SUBJECT TO THE FURTHER CERTIFICATION OF THE "AS CONSTRUCTED" WORKS BY A REGISTERED PROFESSIONAL ENGINEER OF THE PROVINCE OF ONTARIO.

DATE: \_\_\_\_\_ APPROVED BY: \_\_\_\_\_

NO	REVISION	DATE	BY

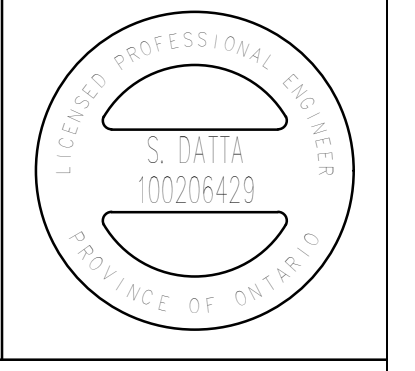

**RTG Systems Inc.**  
ELECTRICAL CONSULTING ENGINEERS  
3518 Mainway Dr., Suite 201 Office: (905) 935-4470  
BURLINGTON ON L7M 1A8 Toronto: (905) 827-7887  
E-MAIL: general@rtgsystems.com

**TOWN OF CALEDON**  
13290 NUNNVILLE ROAD ENCLAVE  
TOWNHOMES  
CONDO SITE LIGHTING

DWG BY	DATE	CHK'D BY	DATE
S.D.	2022.04.07		

SCALE: 1:500 EXCEPT SYMBOLS

DRAWING NO. SHEET 1 OF 1

SL-1

**TOWN OF CALEDON**  
PLANNING  
RECEIVED  
May 2, 2022